


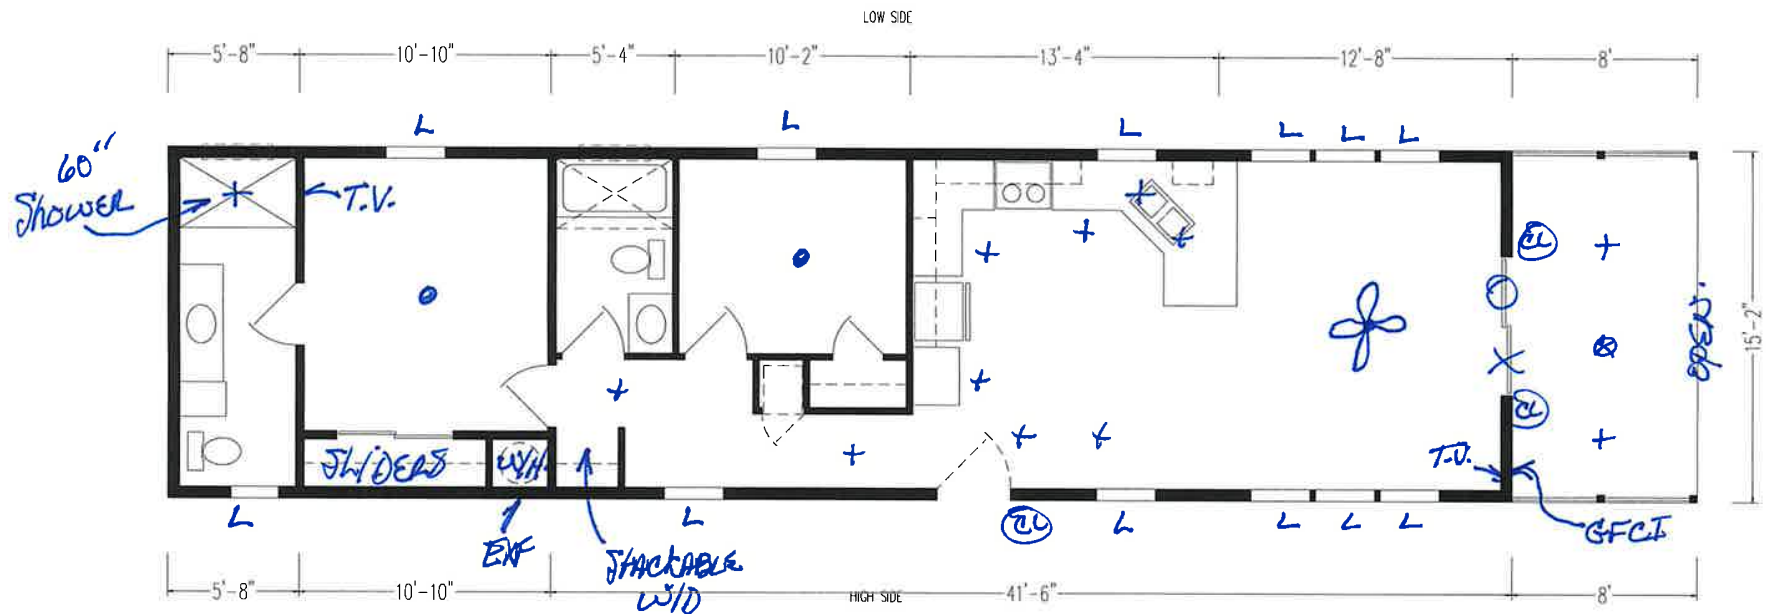

DIVISIONS				SKYLINE			
231	SUGARCREEK						
233	ARKANSAS CITY						
235	SAN JACINTO						
237	WOODLAND						
239	OCALA						
X 241	LEOLA						
243	LANCASTER						
245	McMINNVILLE						
REVISIONS							
B	FLIP PANTRY/REFER, DEL 6" KITCHEN WALL, REV SNACK BAR AND KNEEWALL	8/18/23	SJC				
A	REVISED \$WALLS \$T-1 TO \$T-2 PER MARK-UP	07/20/23	MB				
BOX LENGTH				DRAWING NUMBER			
66'-0"				16-03482-06Q			
DESCRIPTION				DRAWING NUMBER			
6616-2CK-2B				16-03482-06Q			
CHB MODEL NUMBER				DRAWING NUMBER			
1666H22				16-03482-06Q			
DRAWN BY: SJC				DRAWING NUMBER			
DATE: 05/31/2023				16-03482-06Q			
WIND ZONE 15#				16-03482-06Q			
ROOF ZONE S,M,N				16-03482-06Q			
SHEET _____ OF _____				16-03482-06Q			

5802-AB